


8901 Moritz

MS DESIGN
 1643 CLAYTON SPUR CT.
 ST. LOUIS, MO 63011
 PHONE: 314-368-5555

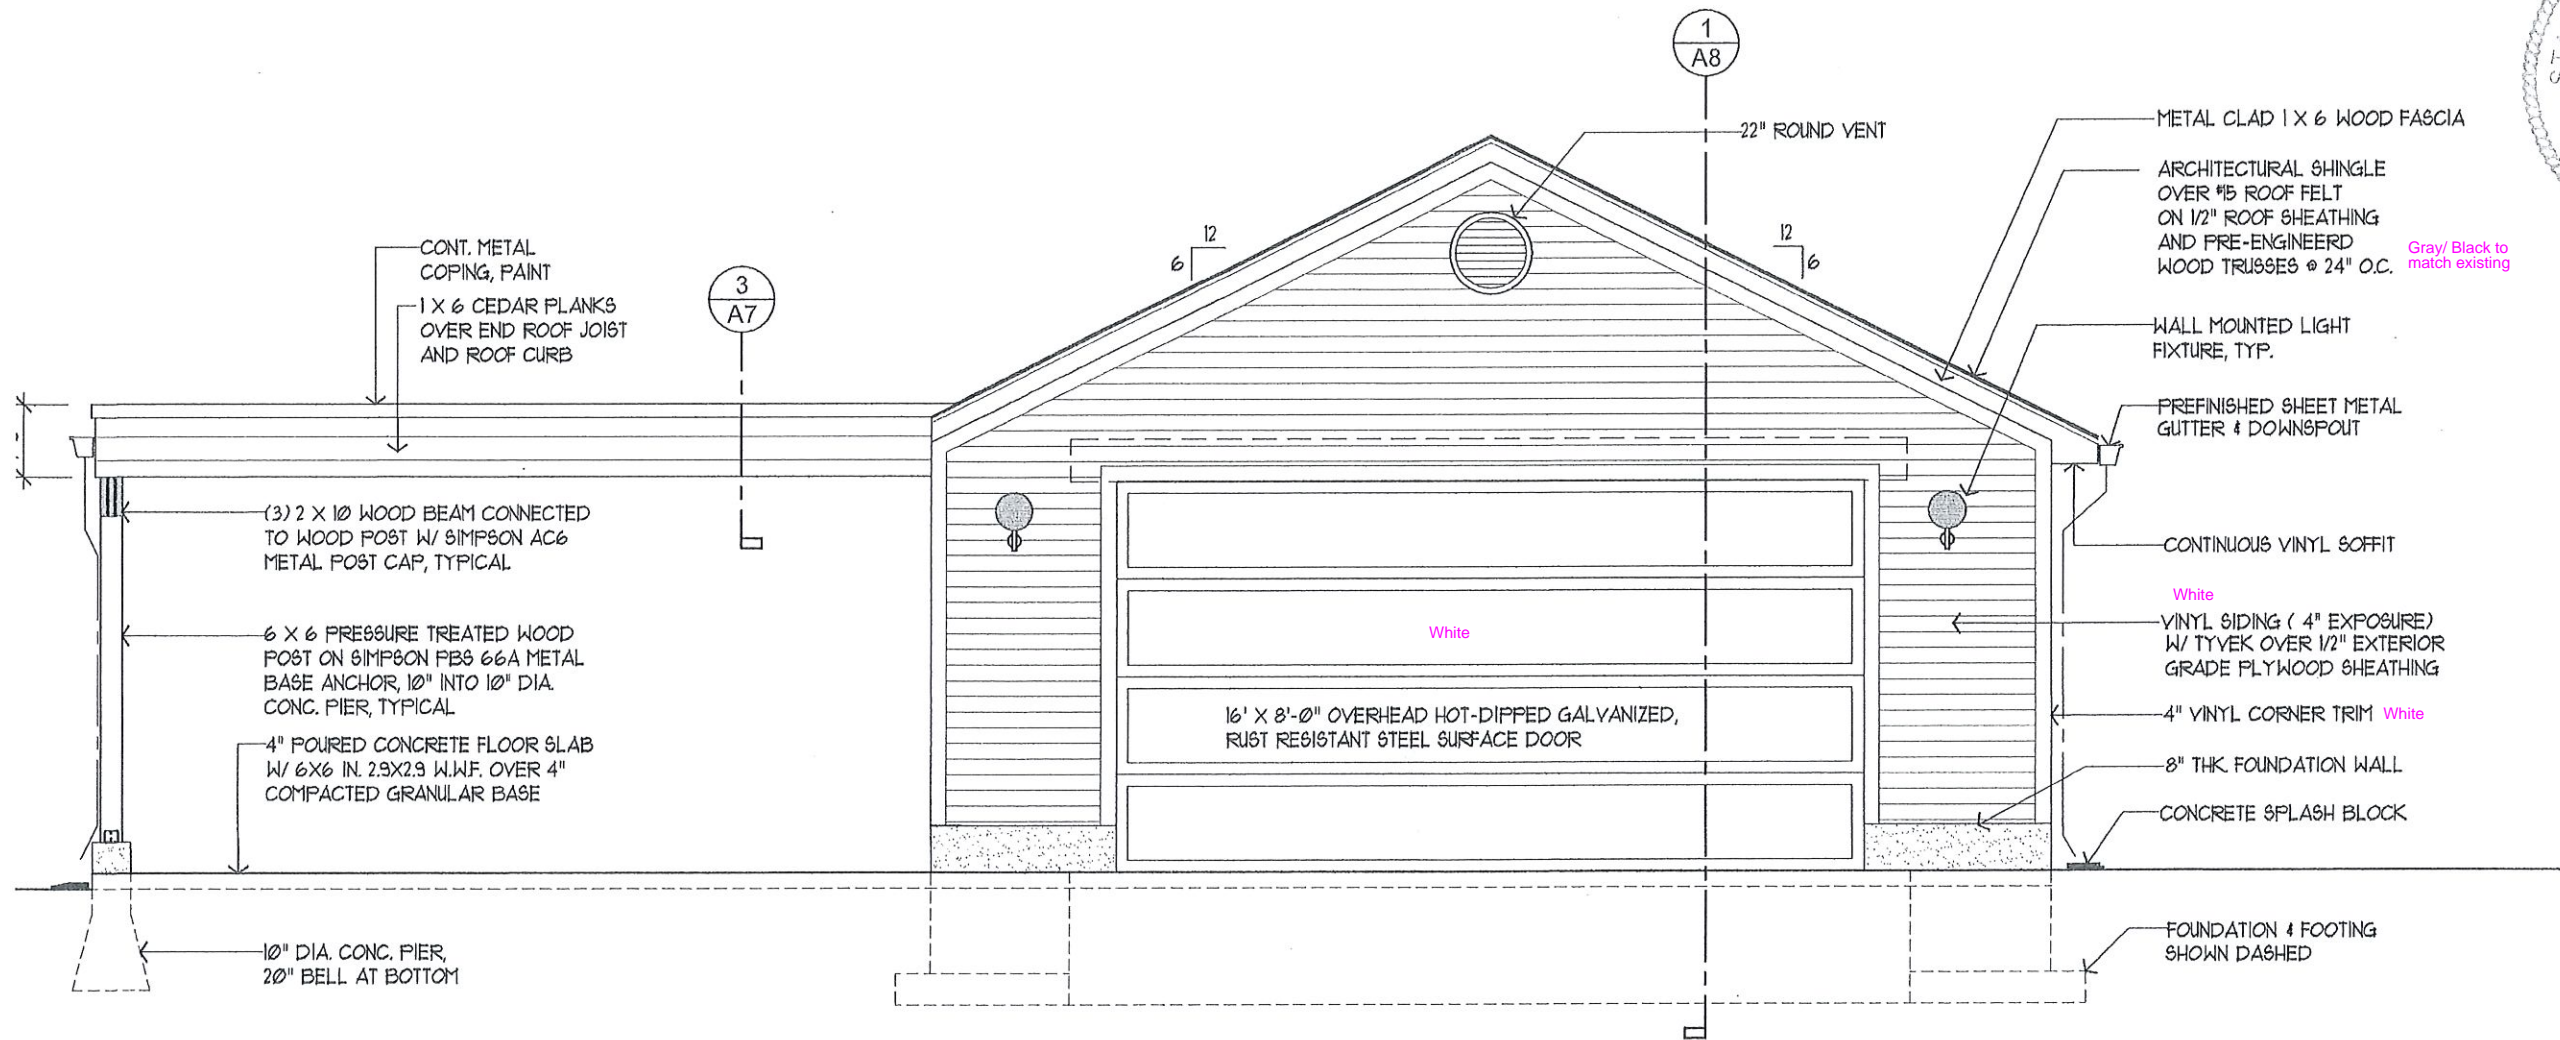


1 SOUTH ELEVATION
 A3 SCALE: 1/4" = 1'-0"

PROJECT NAME
RESIDENTIAL DETACHED GARAGE & COVERED PATIO
 8901 MORITZ AVE, BRENTWOOD, MO

REV. 05-02-20

DATE 04-30-20

SHEET **A3**

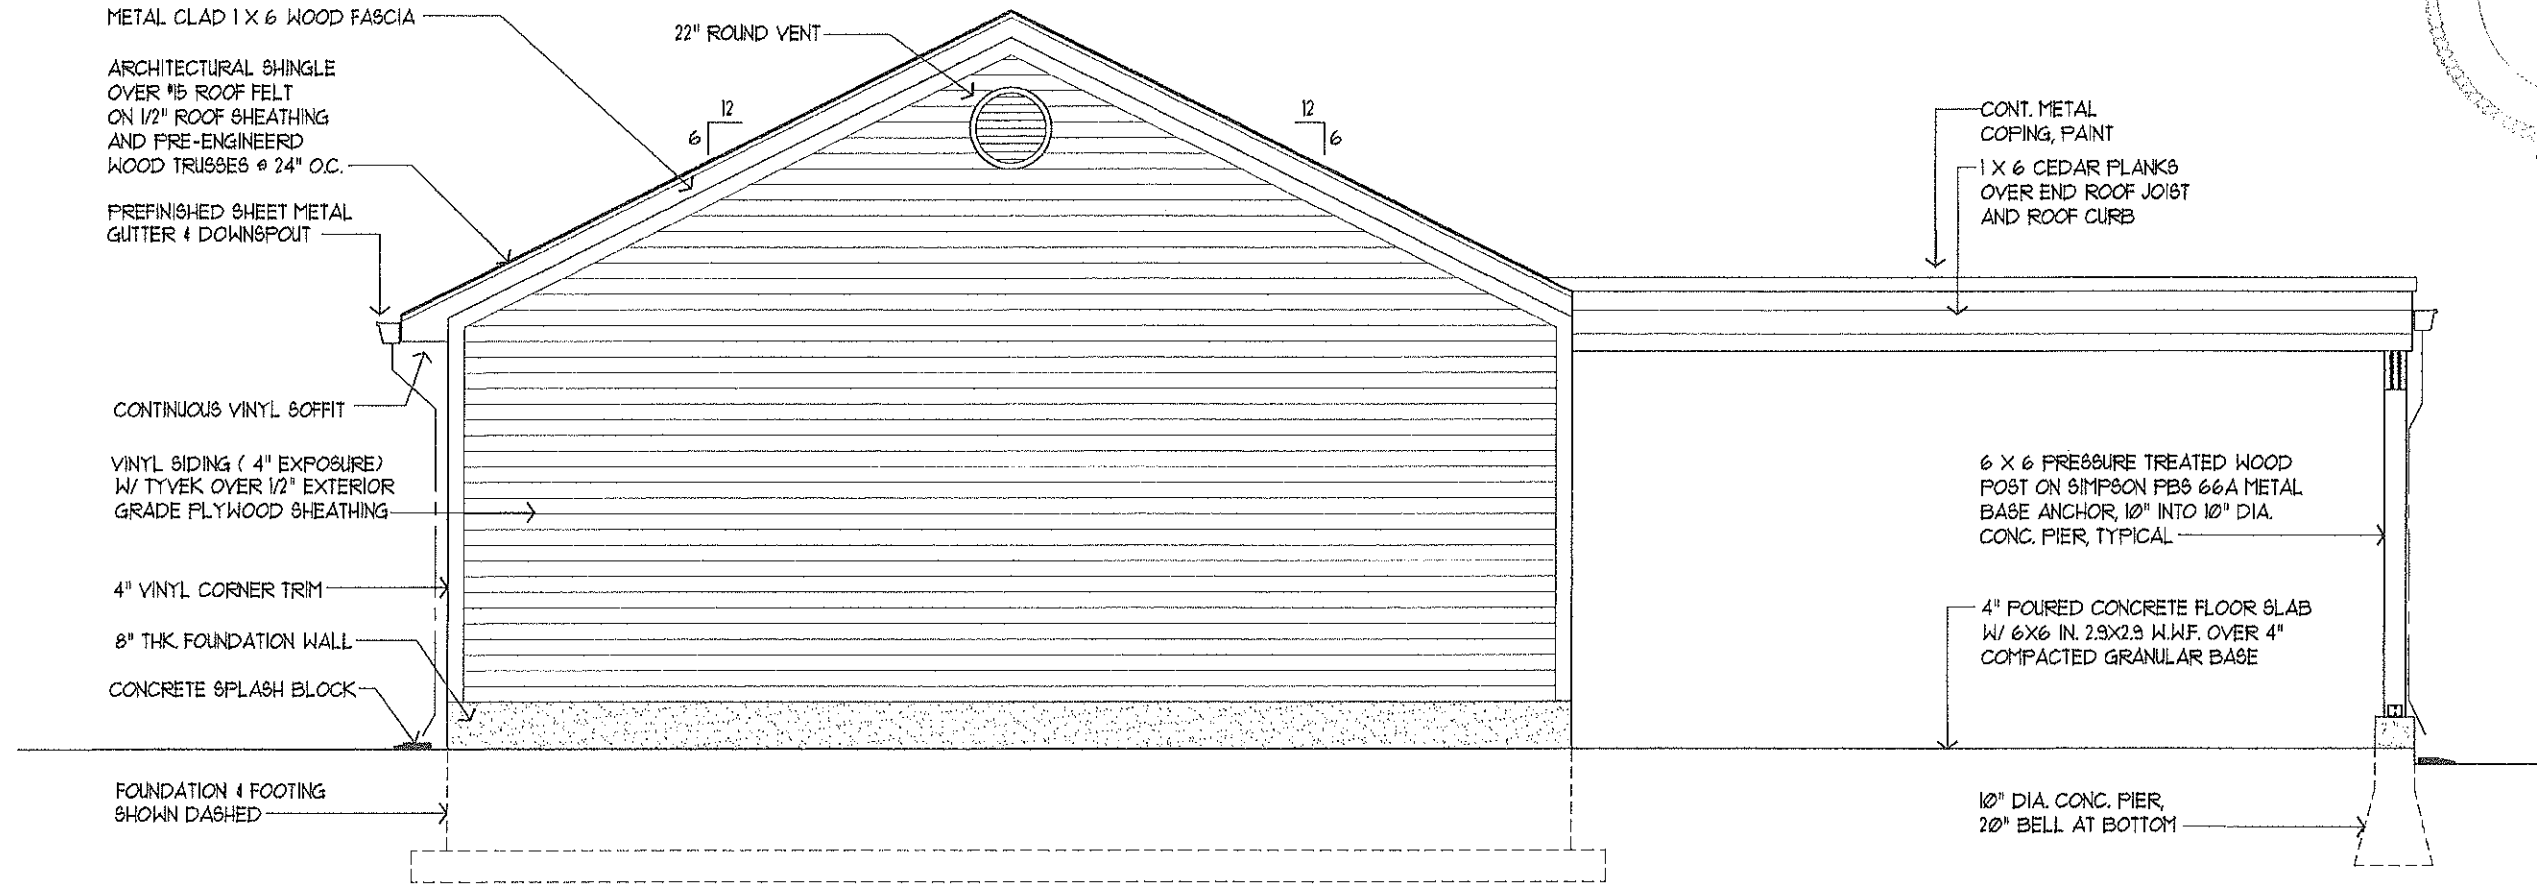


1 NORTH ELEVATION
 A4 SCALE: 1/4" = 1'-0"

PROJECT NAME
RESIDENTIAL DETACHED GARAGE & COVERED PATIO
 8901 MORITZ AVE, BRENTWOOD, MO

REV. 05-02-20

DATE 04-30-20

SHEET A4

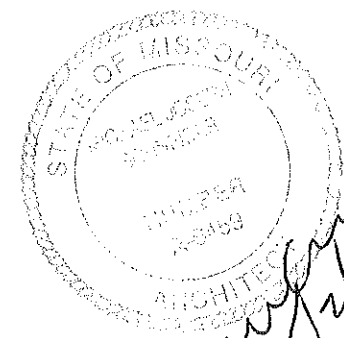

Handwritten signature and initials


RESIDENTIAL DETACHED GARAGE & COVERED PATIO
 8901 MORITZ AVE., BRENTWOOD, MO

PROJECT NAME



REV. 05-02-20

DATE 04-30-20

SHEET A5

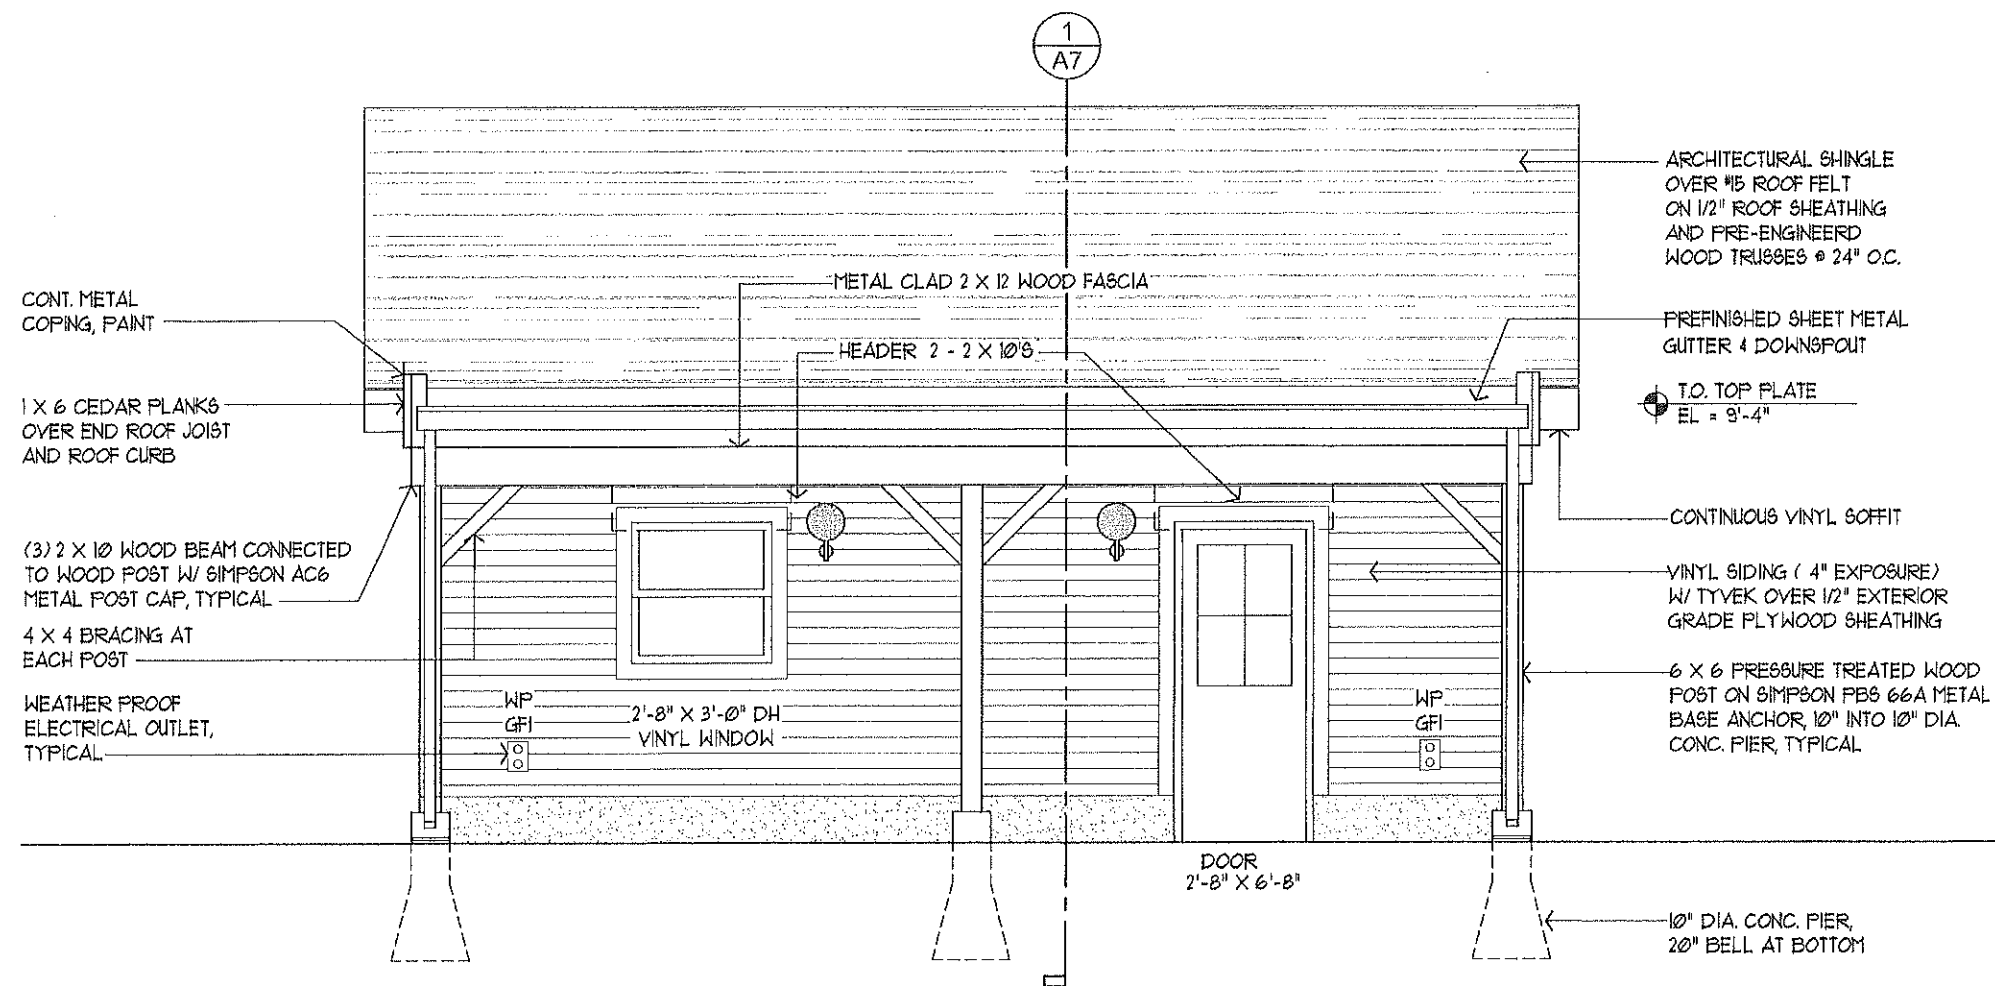

1 WEST ELEVATION
 A5 SCALE: 1/4" = 1'-0"

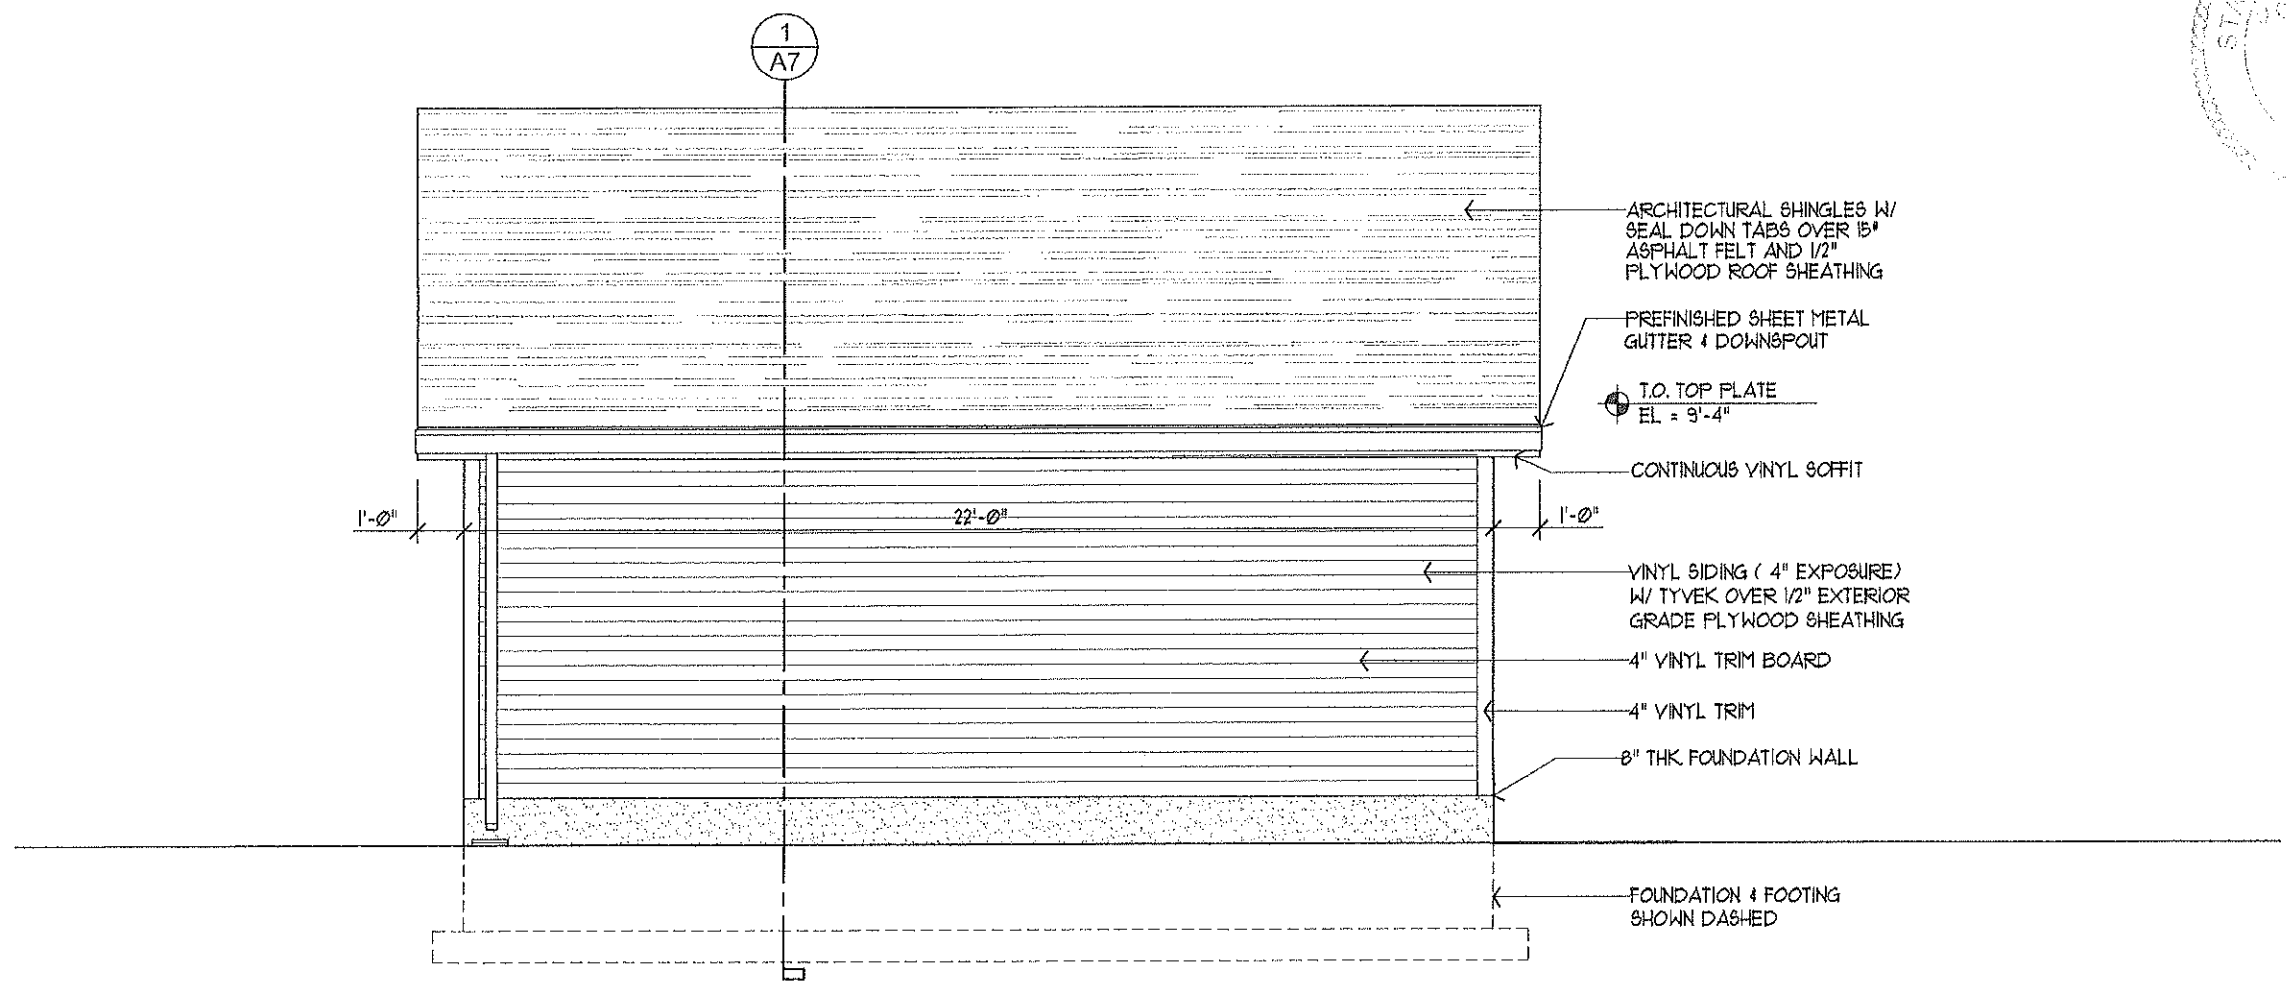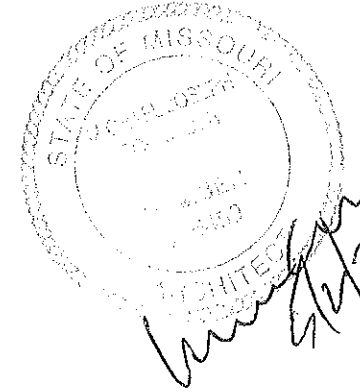

ARCHITECTURAL SHINGLES W/
 SEAL DOWN TABS OVER 15'
 ASPHALT FELT AND 1/2"
 PLYWOOD ROOF SHEATHING

PREFINISHED SHEET METAL
 GUTTER & DOWNSPOUT

I.O. TOP PLATE
 EL. = 9'-4"

CONTINUOUS VINYL SOFFIT

VINYL SIDING (4" EXPOSURE)
 W/ TYVEK OVER 1/2" EXTERIOR
 GRADE PLYWOOD SHEATHING

4" VINYL TRIM BOARD

4" VINYL TRIM

8" THK. FOUNDATION WALL

FOUNDATION & FOOTING
 SHOWN DASHED

1
 A6 EAST ELEVATION
 SCALE: 1/4" = 1'-0"

PROJECT NAME
RESIDENTIAL DETACHED GARAGE & COVERED PATIO
 8901 MORITZ AVE, BRENTWOOD, MO

REV. 05-02-20

DATE 04-30-20

SHEET **A6**